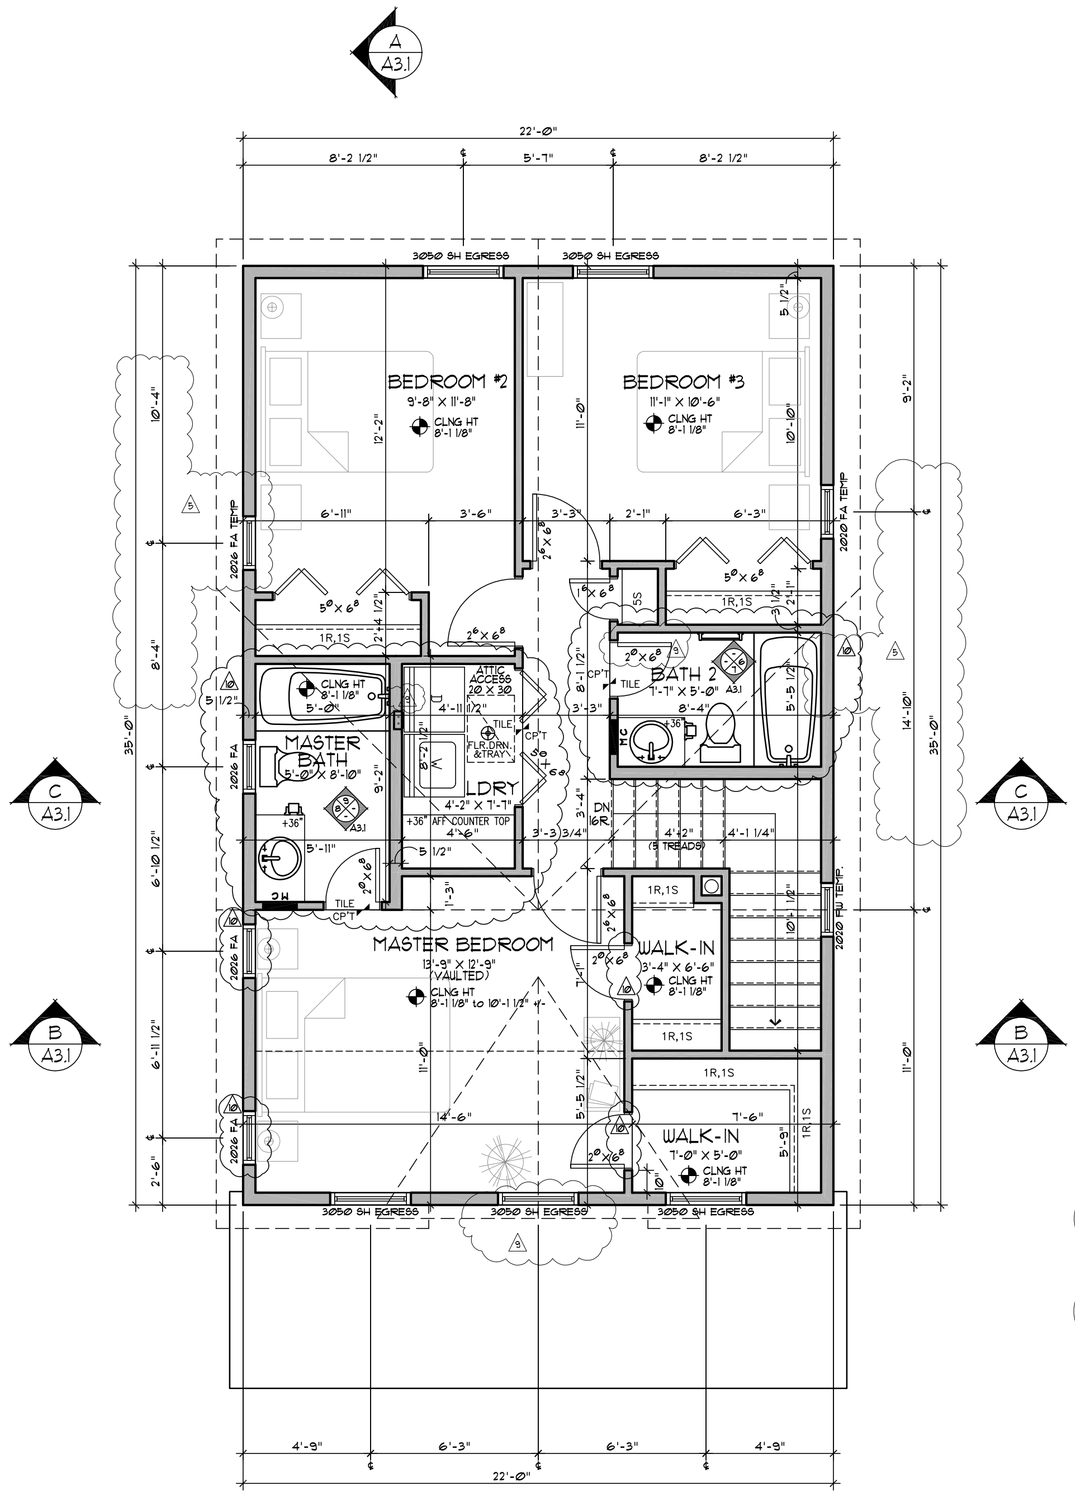

UPPER LEVEL FLOOR PLAN

735 S.F.

SCALE: 1/4" = 1'-0" (11"X17" SHEET : 1/8" = 1'-0")

TOTAL SQUARE FOOTAGE: 1463 S.F.

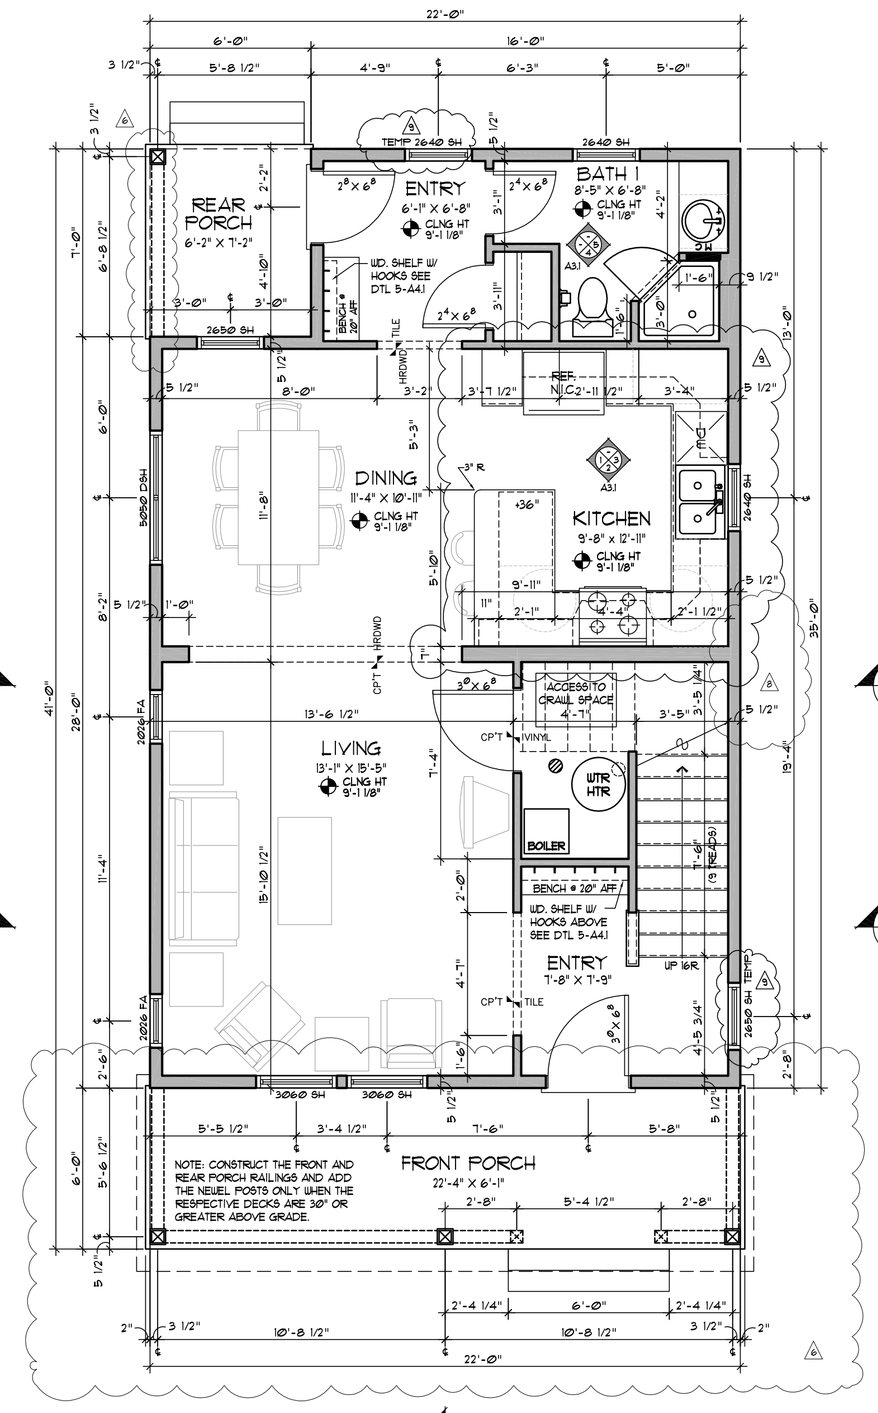

MAIN LEVEL FLOOR PLAN

728 S.F.

SCALE: 1/4" = 1'-0" (11"X17" SHEET : 1/8" = 1'-0")

TOTAL SQUARE FOOTAGE: 1463 S.F.

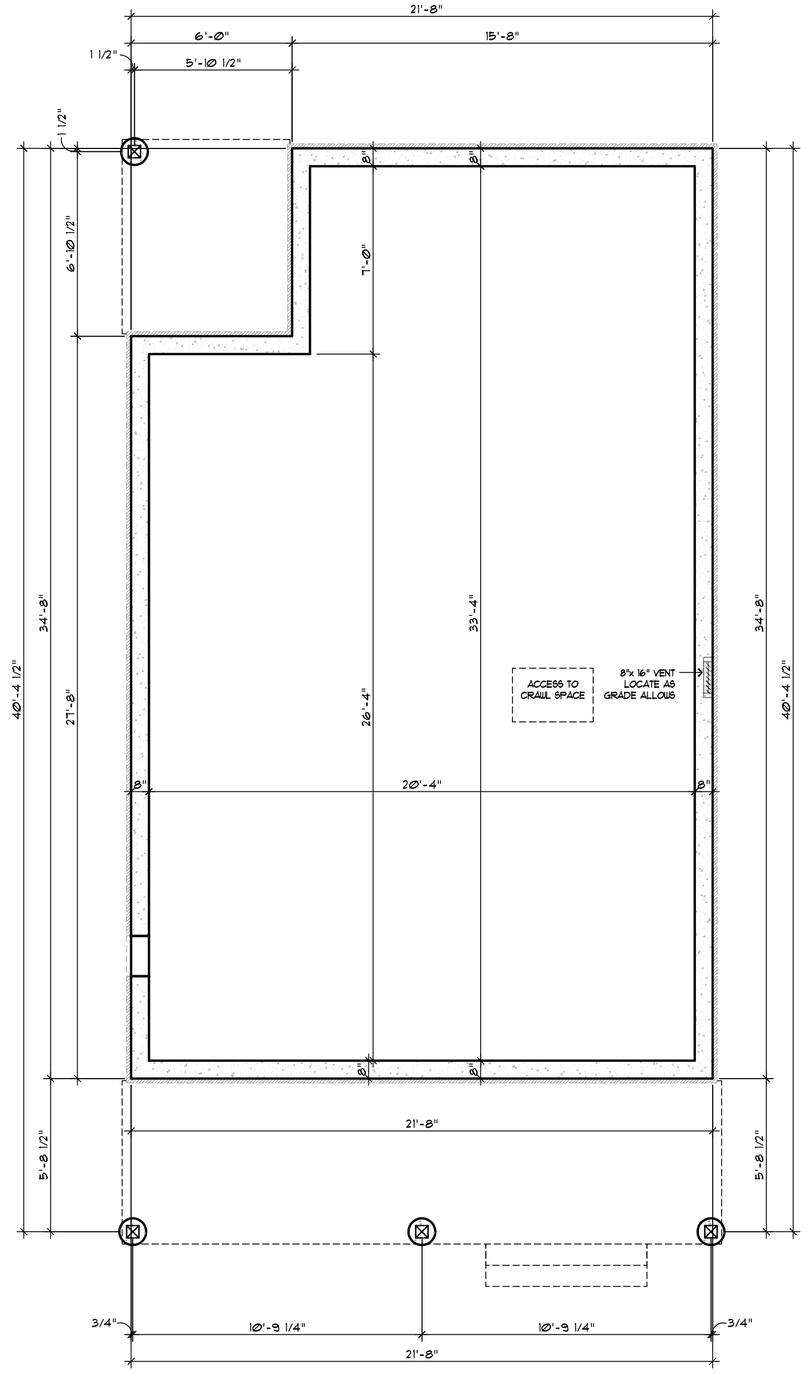

FOUNDATION PLAN

SCALE: 1/4" = 1'-0" (11"X17" SHEET : 1/8" = 1'-0")

© 2006 WOLFF LYON ARCHITECTS EXPRESSLY RESERVES ITS COMMON LAW COPYRIGHT AND OTHER PROPERTY RIGHTS IN THESE PLANS. THESE PLANS ARE NOT TO BE REPRODUCED, CHANGED, OR COPIED IN ANY FORM OR MANNER WHATSOEVER, NOR ARE THEY TO BE ASSIGNED TO ANY THIRD PARTY WITHOUT FIRST OBTAINING THE EXPRESSED WRITTEN PERMISSION AND CONSENT OF WOLFF LYON ARCHITECTS

WOLFF • LYON
ARCHITECTS

• WELLINGTON •
NEIGHBORHOOD
BRECKENRIDGE, COLORADO

CLIENT:
POPLARHOUSE LLC
777 PEARL ST. SUITE 200
BOULDER, CO 80302

ARCHITECT:
WOLFF-LYON ARCHITECTS
777 PEARL STREET – SUITE 210
BOULDER, CO 80302
T: (303) 447-2788
F: (303) 447-2968

STRUCTURAL ENGINEER:
MOUNTAIN DESIGN GROUP LLC
29713 TROUTDALE SCENIC DR., STE, B-1
EVERGREEN, CO 80439
T: (303) 670-8811
F: (303) 670-9472

LICENSED ARCHITECT
JOHN THOMAS LYON JR.
B-2451
STATE OF COLORADO

JUNIPER

• WELLINGTON •
NEIGHBORHOOD
BRECKENRIDGE, COLORADO

ISSUE DATES:

DATE	DESCRIPTION
01.04.06	S40 REVIEW
02.13.06	S40 REVIEW
03.10.06	WOLFF LYON REDLINES
04.13.06	WOLFF LYON REDLINES
05.23.06	CONSTRUCTION SET

REVISIONS:

DATE		DESCRIPTION
06.21.06	ENTIRE PAGE	REVISIONS 1
07.28.06		REVISIONS 2
08.09.06		REVISIONS 3
01.25.10		REVISIONS 4
05.12.11		REVISIONS 5

DRAWN BY:
PROJECT No.: 9909

FLOOR PLANS

A1.1